


St Mary's Magdalene Catholic Church

Simpsonville, South Carolina

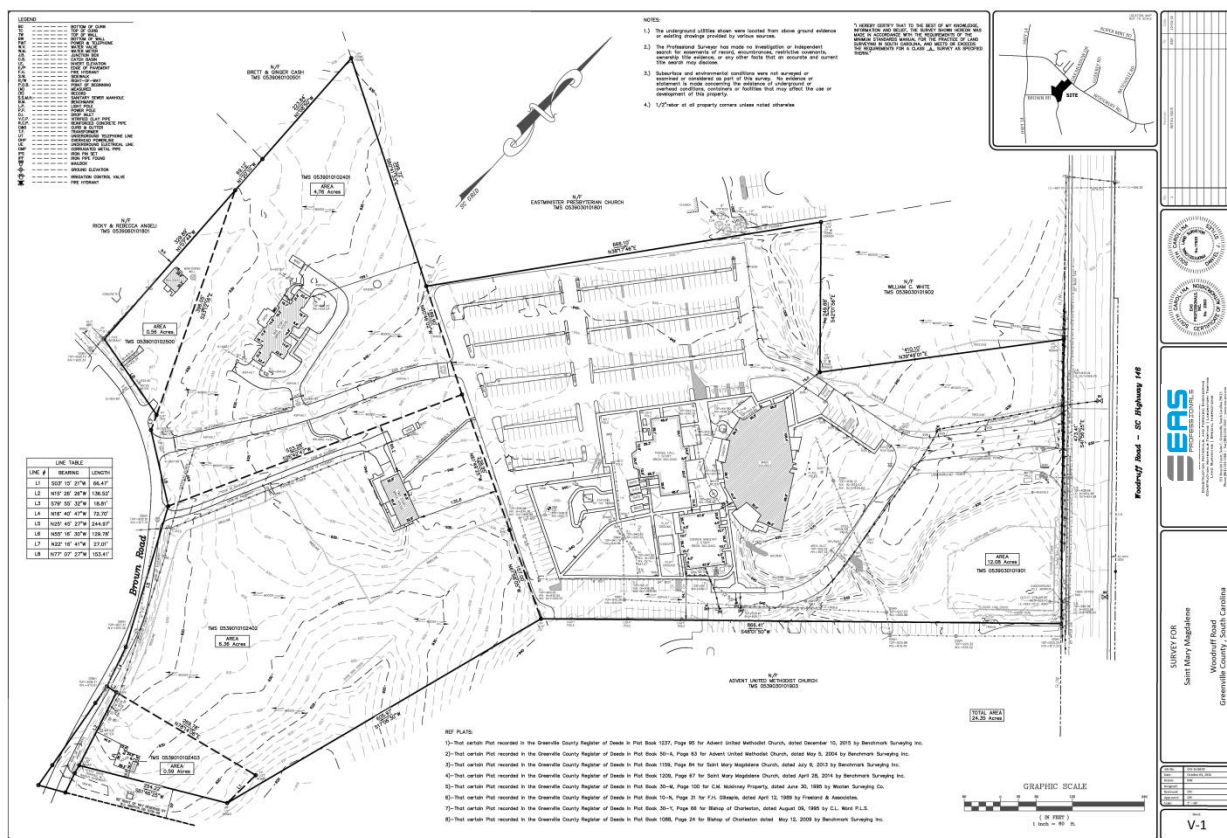

Surveys for St. Mary Magdalene Catholic Church:

- Completed Topographic Survey for Master Planning Project
- Completed Campus AS-Built Survey for Master Planning Project

EAS believes in the importance of giving back to the community. The survey work included one foot contours, location of underground utilities, pipe sizes and flow direction.

